
STATE OF UTAH DEPARTMENT OF NATURAL RESOURCES DIVISION OF OIL, GAS AND MINING

1594 West North Temple - Suite 1210 Box 145801 Salt Lake City, Utah 84114-5801 Telephone: (801) 538-5291 Fax: (801) 359-3940

LARGE MINING OPERATIONS PROGRESS REPORT January 1, 2011 to December 31, 2011

The information required in this form is based on provisions of the Mined Land Reclamation Act, Title 40-8, and the R647 rules under the Utah Minerals Regulatory Program.

 Mine Permit Number: M/051/0013 Mine Name: Center Creek Quarry Name of Operator/Permittee: Geneva Rock Products, Inc. Note: If Operator's address, company representative or phone number have changed, please provide a for the Notice of Intention together with form MR-REV available on the Division's web page at 	
Note: If Operator's address, company representative or phone number have changed, please provide a for the Notice of Intention together with form MR-REV available on the Division's web page at	
for the Notice of Intention together with form MR-REV available on the Division's web page at	
https://fs.ogm.utah.gov/pub/mines/minerals_related/forms/MR-REV.pdf.	replacement page
4. Report the gross amount of ore mined and waste moved:	
Gross Ore Minedyd ³	
Waste Material Movedyd ³	
5. Disturbance at the end of 2010 13.00 Acres	
New Disturbance Created during 2011 O Acres	
Area Reclaimed and Fully Released durin: 2011 Acres	
Total Disturbed Area at the end of 2011 13.00 Acres*	
Permitted/Bonded Acreage 64.00 Acres	
*The total disturbed area should not be greater than the permitted/bonded acrea	ige
6. Briefly describe the reclamation work performed during the past year. (Submit SITE (https://fs.ogm.utah.gov/pub/mines/minerals_related/forms/MR-SITE.pdf full or partial bond/site release). Attach additional sheets if needed. No reclamation work has been performed during this period.	form MR- f) to apply for
7. For large mines, include an updated map depicting surface disturbance and recl performed during the year (Rule R647-4-105).	amation
I hereby certify, under penalties of law, the information provided in this report is t	true and
orrect to the best of my knowledge and belief.	
Name (Typed or Print): Brent R. Sumsion	1-15
Title of Operator: Properties and Environmental Manager	
Signature of Operator:	
Date: Jan. 30, 2012	
	RECEI\

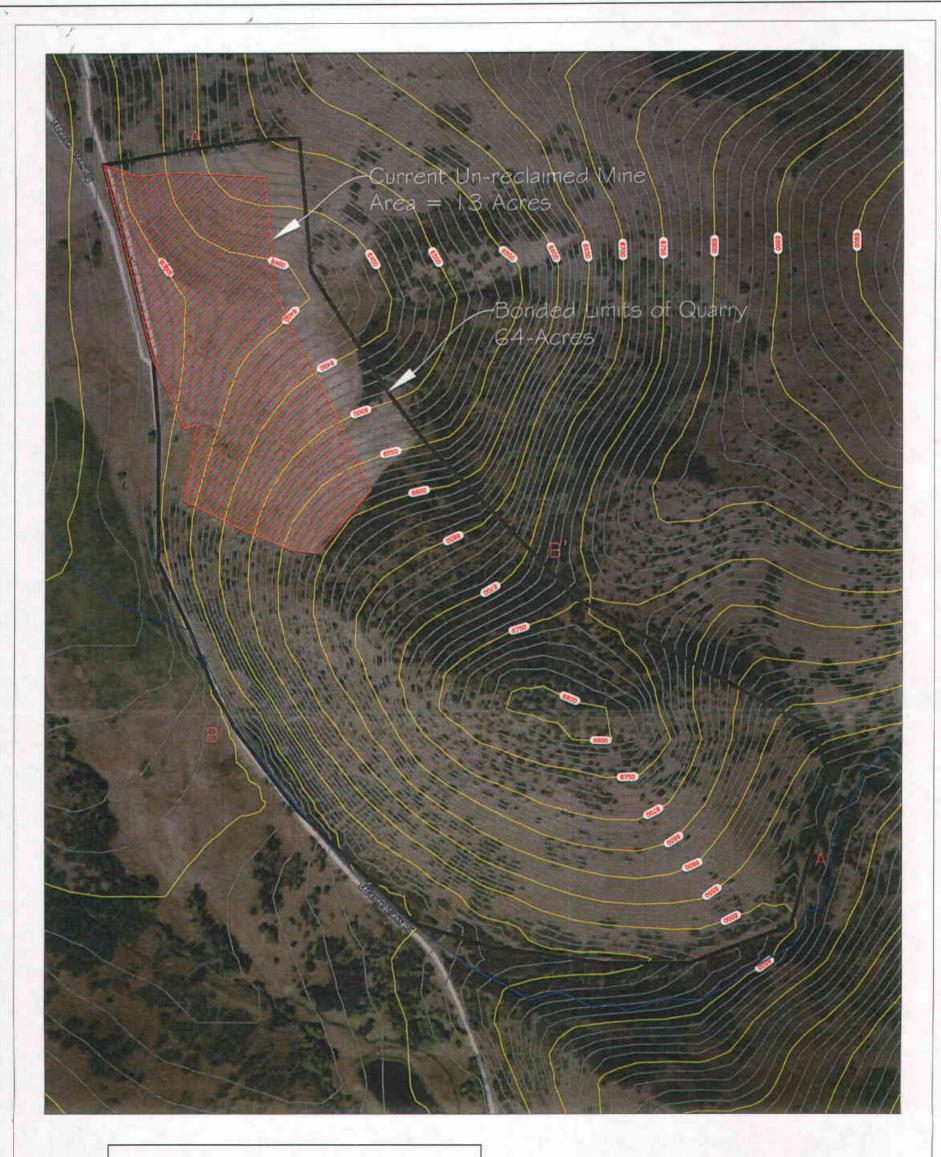

DIV. OF OIL, GAS & MINING JAN 3 0 2012 Legend

Major 50' Contour Minor 10' Contour Water Course Quarry Bdy Existing Mine Footprint



APPROVED

SEP 0 9 2011

DIV. OIL GAS & MINING

Scale	1"=300'
-------	---------

Date: 12-17-09 Dwg. No.	ISSUED FOR INTERNAL REVIEW	Reviale
Checked: BS/CC Approved:	DOGM NOI Figure 3	
Drawn: B SUMSION	Contain Cico.	

_			
Œ	FOR	INTERNAL REVIEW	F

NO.	DATE:	DESCRIPTION:	BY

Geneva	Rock Center Creek Quari	ry
	Original Contours	



Geneva Rock Products, Inc. 1556 West 400 North Orem, Utah 84057 801-765-7800